

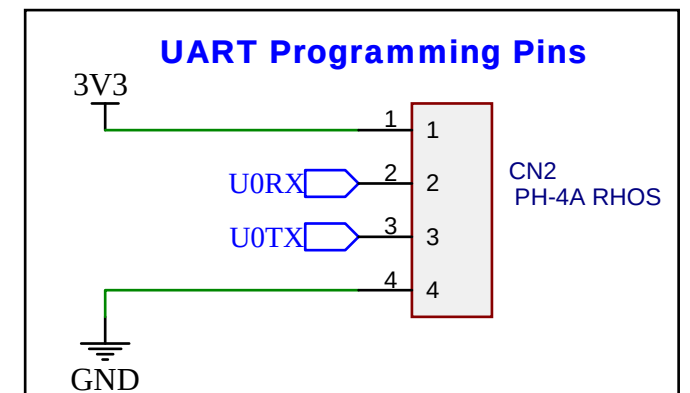
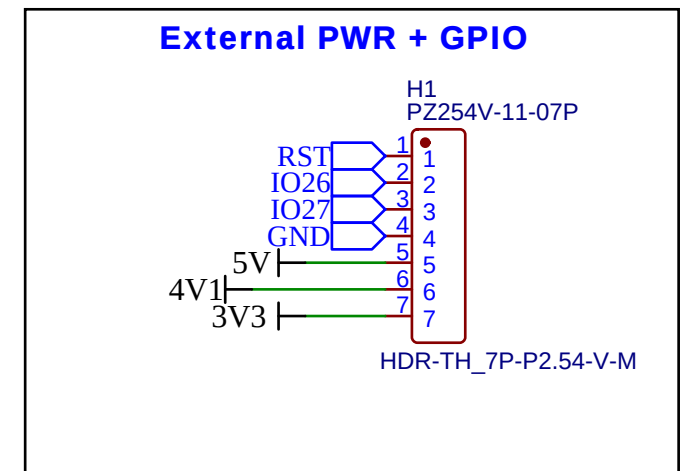
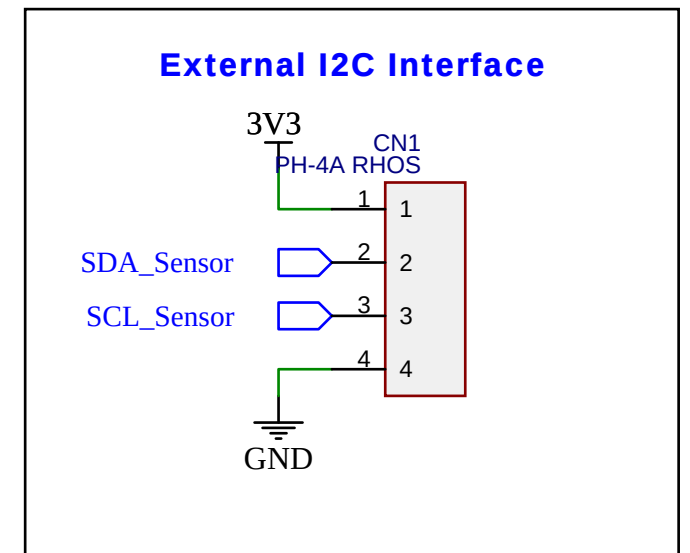
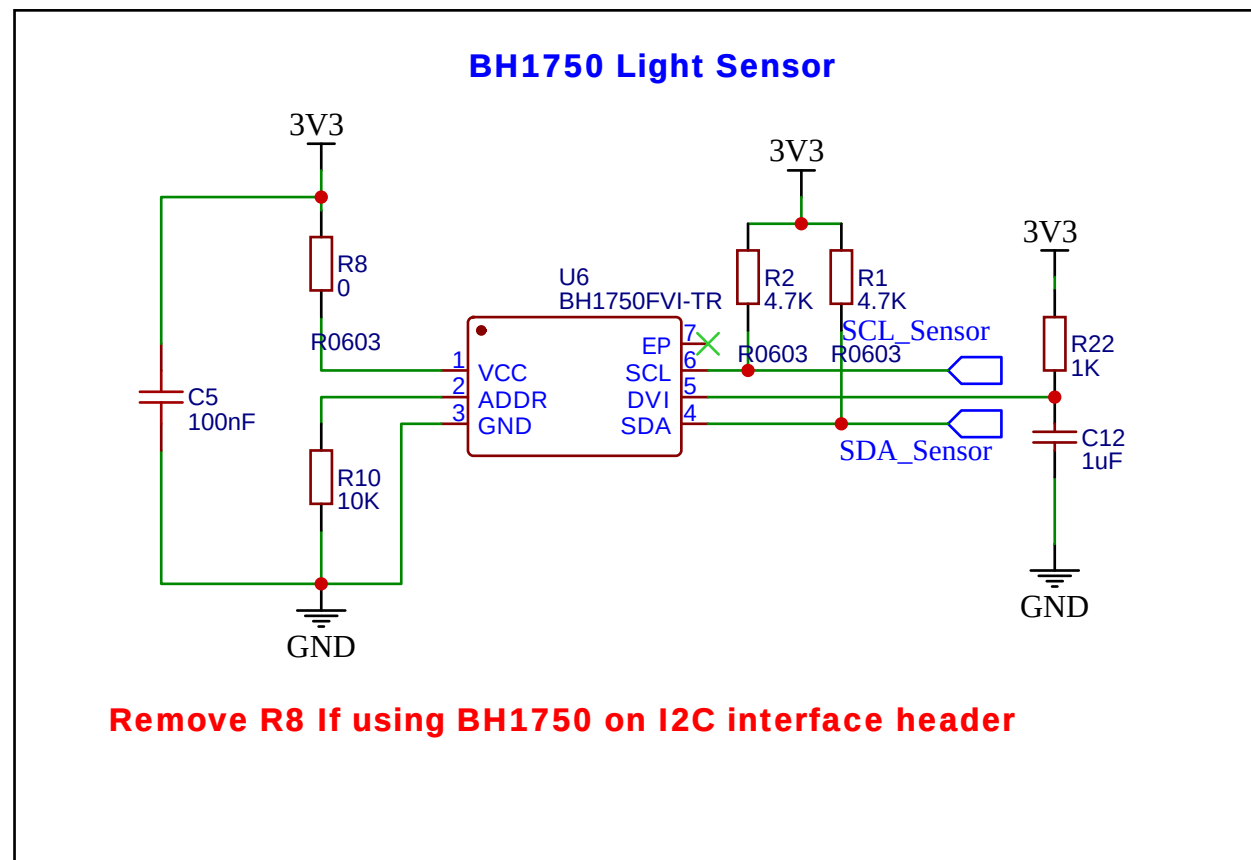
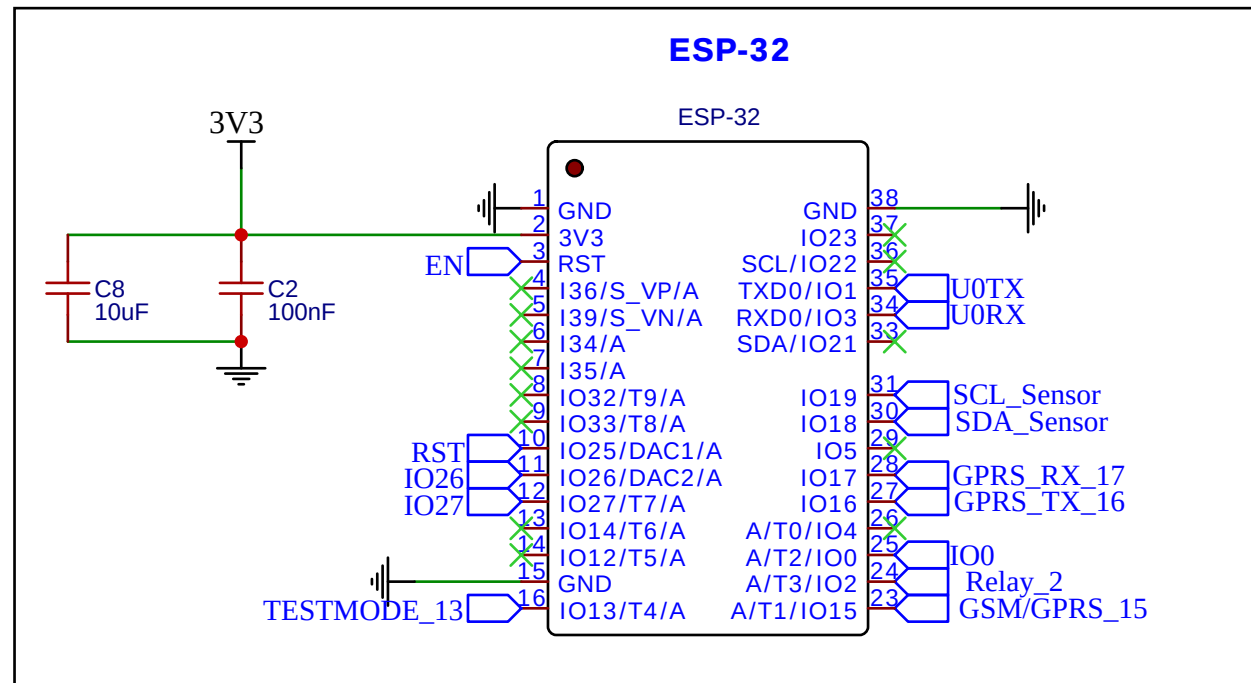
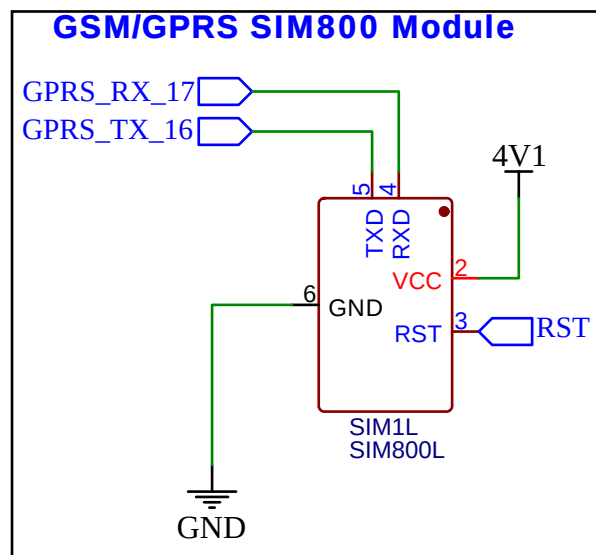
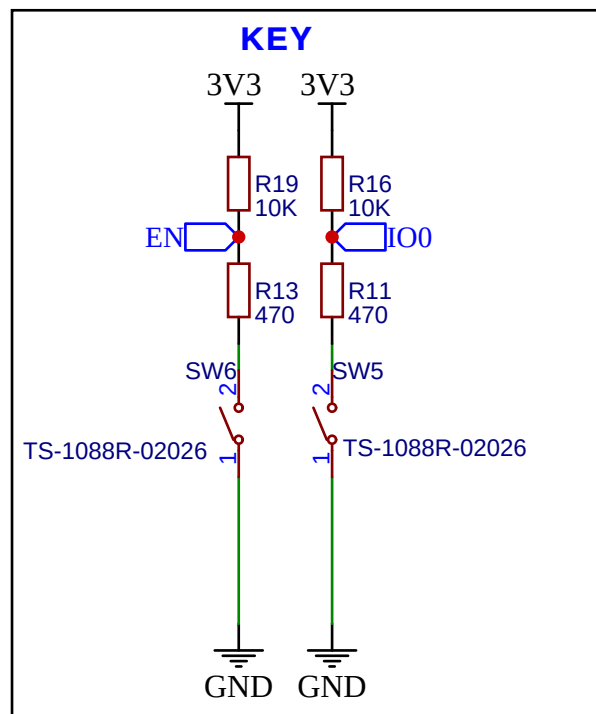
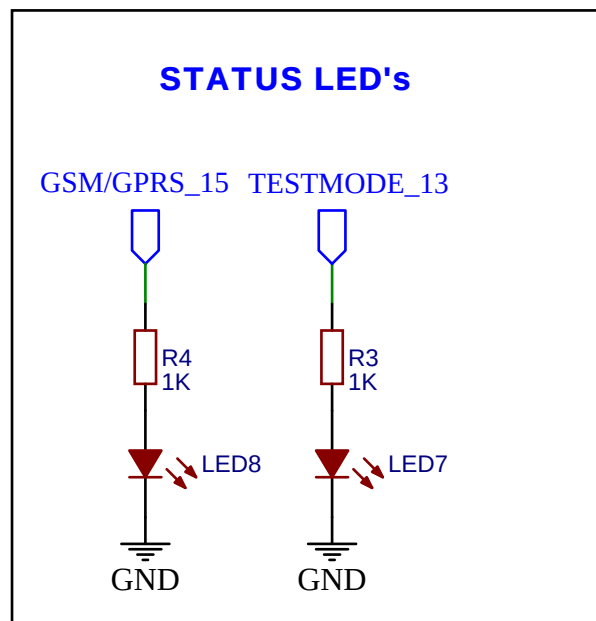
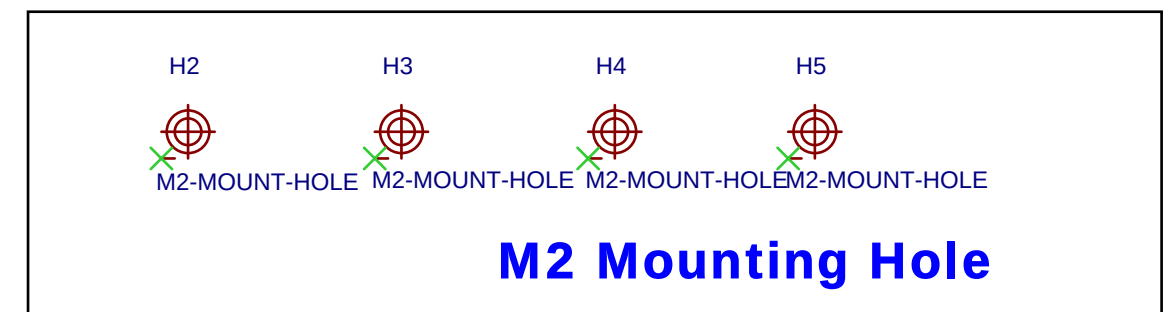
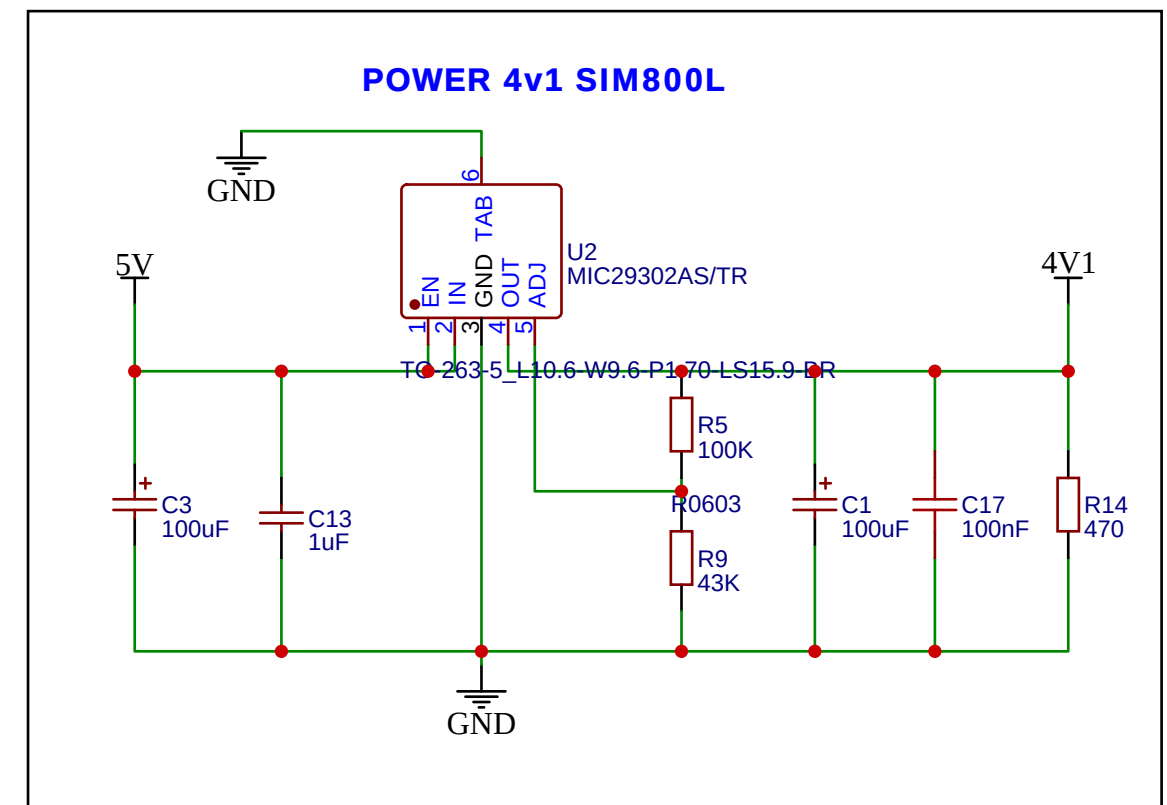


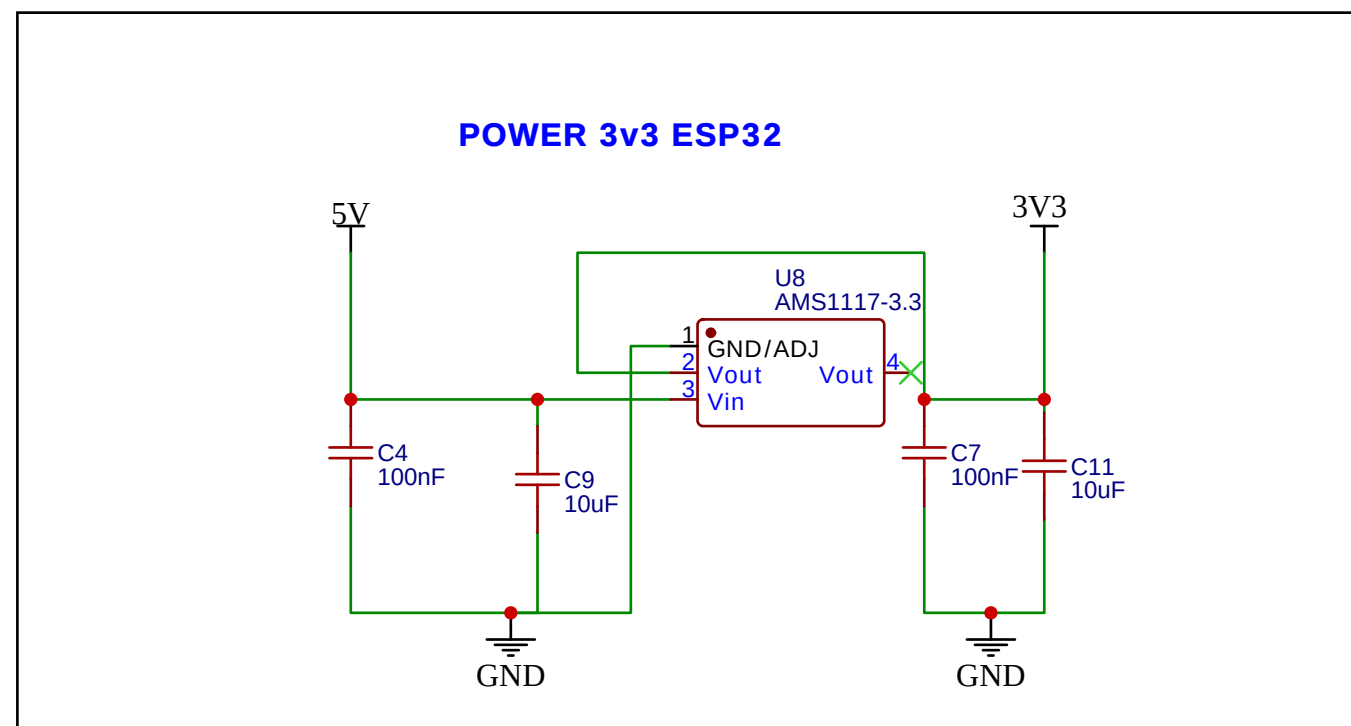

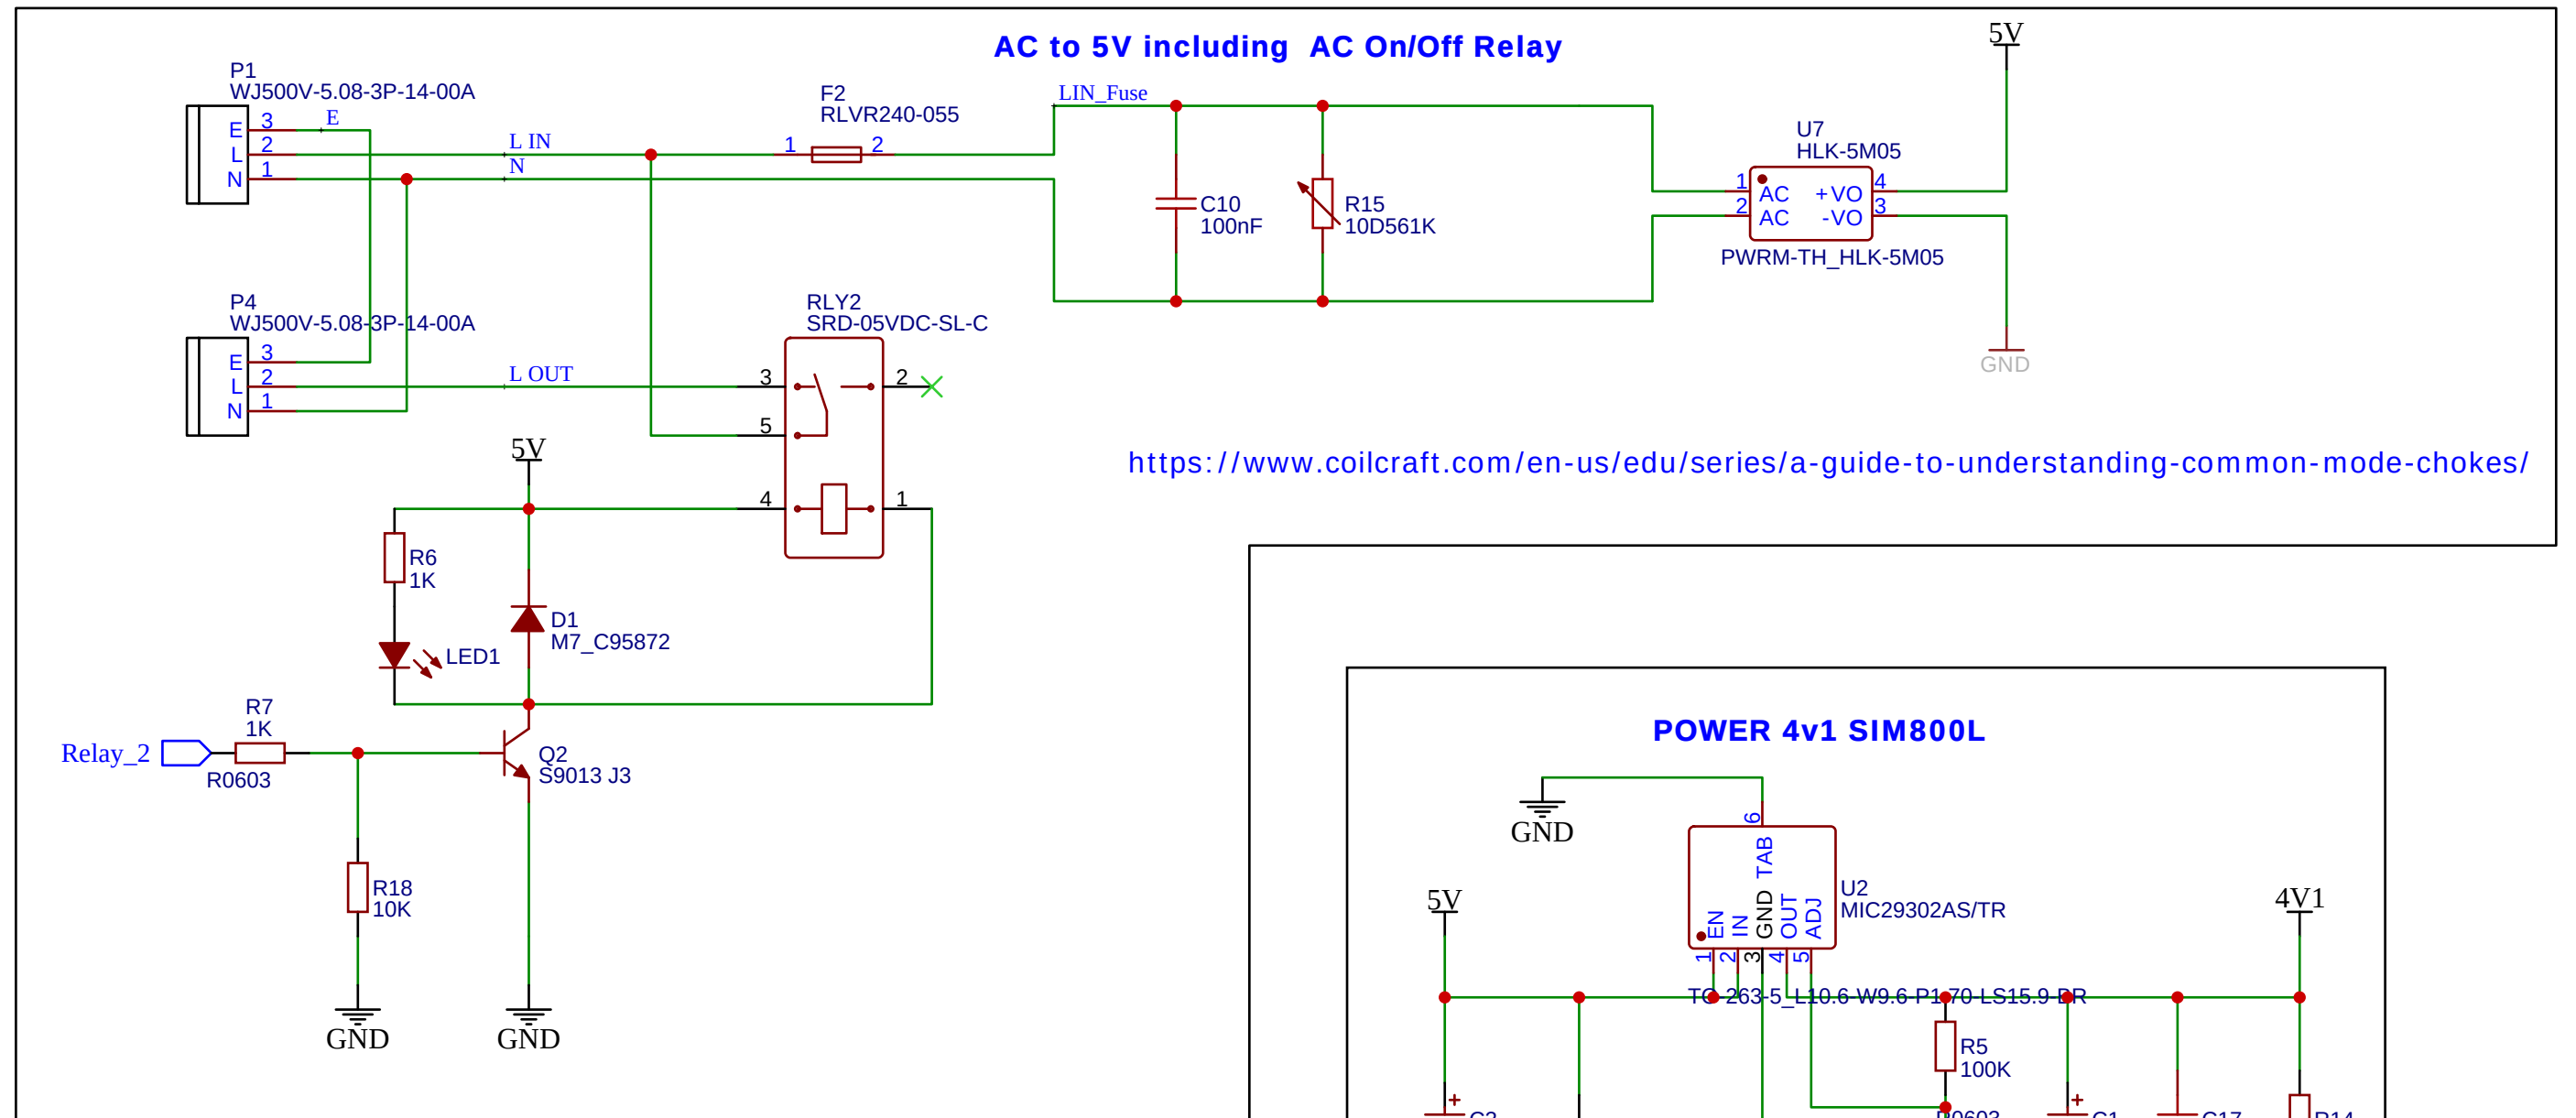

TITLE: ESP_AC_SIM800L v1.0		REV: 1.0
EasyEDA	Company: Linniem	Sheet: 1/2
	Date: 2021-11-11	Drawn By: caoilte donohoe